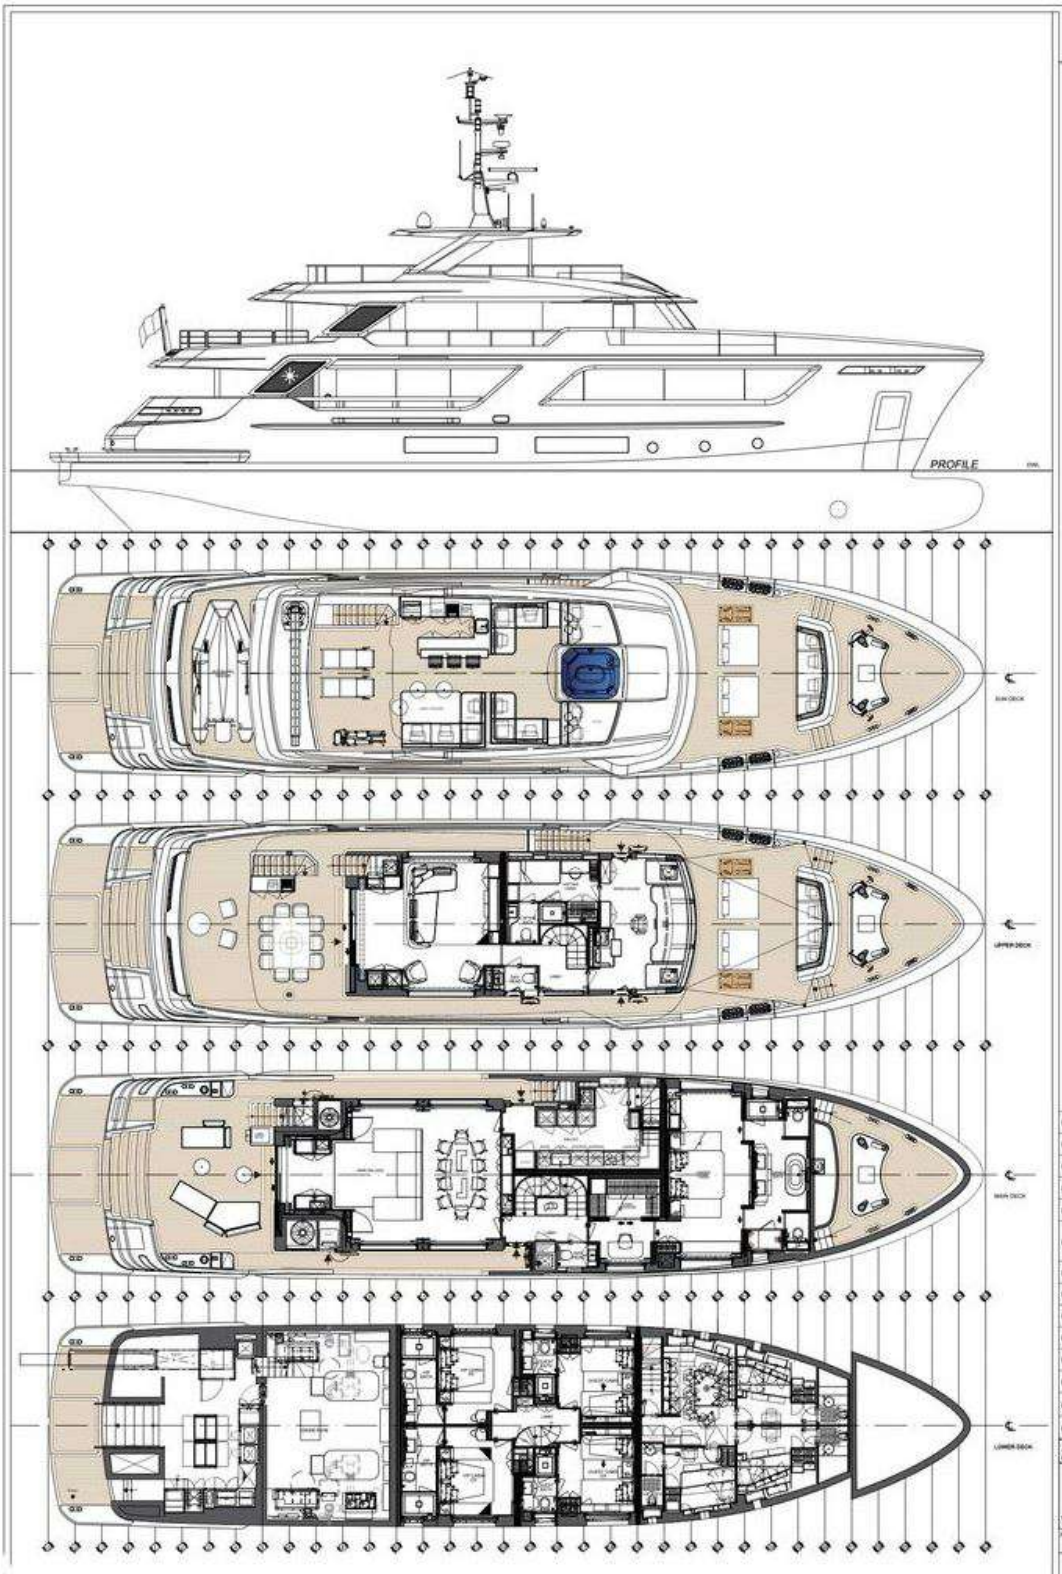

115.28

REV.	Data/Date	Descrizione Aggiornamento/Updating Description	Drawn by	Approved by
REV.14	23/03/2023	AGGIORNAMENTO AS BUILT	CdM	
REV.13	02/03/2023	AGGIORNAMENTO AS BUILT	CdM	
REV.12	20/05/2021	AGGIORNAMENTO LAYOUT ZONA CREW LWD	CdM	
REV.11	27/04/2021	AGGIORNAMENTO BAGNO ARMATORE, BAGNI CABINE VIP, LAYOUT SALONE UD E OPZIONI DI LAYOUT DEL SALONE MD	FPD	
REV.10	13/04/2021	AGGIORNAMENTO SALONE UD CON INSERIMENTO ELETTRODOMESTICI E CAMBIO MATERIALE A CALPESTIO	FPD	
REV.09	16/03/2021	AGGIORNAMENTO CON SPESSORI DI COMPARTIMENTAZIONE FANCOIL, G.E. LAYOUT AGGIORNATI: CABINE E BAGNI VIP, GUEST E OWNER AREA, LOBBY LOWDUCI, DAY HEAD MD, GALLEY.	FPD	
REV.08	26/10/2020	AGGIORNAMENTO CON SPESSORI DI COMPARTIMENTAZIONE FANCOIL, G.E. AGGIORNAMENTO PG CON BIKE 20 DA 3D.	FPD	
REV.07	23/04/2020	AGGIORNAMENTO PG SECONDO CC DEL 16/4/2020	FPD	
REV.06	22/04/2020	GENERAL UPDATE	FPD	
REV.05	15/04/2020	GENERAL UPDATE	FPD	
REV.04	6/04/2020	GENERAL UPDATE	FPD	
REV.03	14/01/2020	GENERAL UPDATE	FPD	
REV.02	03/10/2019	GENERAL UPDATE	FPD	
REV.01	17/09/2019	GENERAL UPDATE	FPD	

01

CANTIERE DELLE MARCHE

FRANCESCO PACCOSTAZI DESIGN

Hull number	Rule Approval	Date 09/10/2018	Drawn by FDP
		Scale 1:75	Approved by

CDM 115.28

PRELIMINARY GENERAL ARRANGEMENT

Drawing N° 1

Tab. N° 01

REPLICATION, UTILIZATION OR COMUNICATION TO THIRD PERSON OF THIS DRAWING, IS STRICKTLY FORBIDDEN.